

Floor 6

Suite 640

~2,139 SQFT

Low-Rise — As Built


- 4 Private Offices
- 1 Open Area with Sink & Cabinetry
- 1 Huddle Room

Jim Collins

jcollins@shorenstein.com

(415) 352-7239

Lic. #00860991

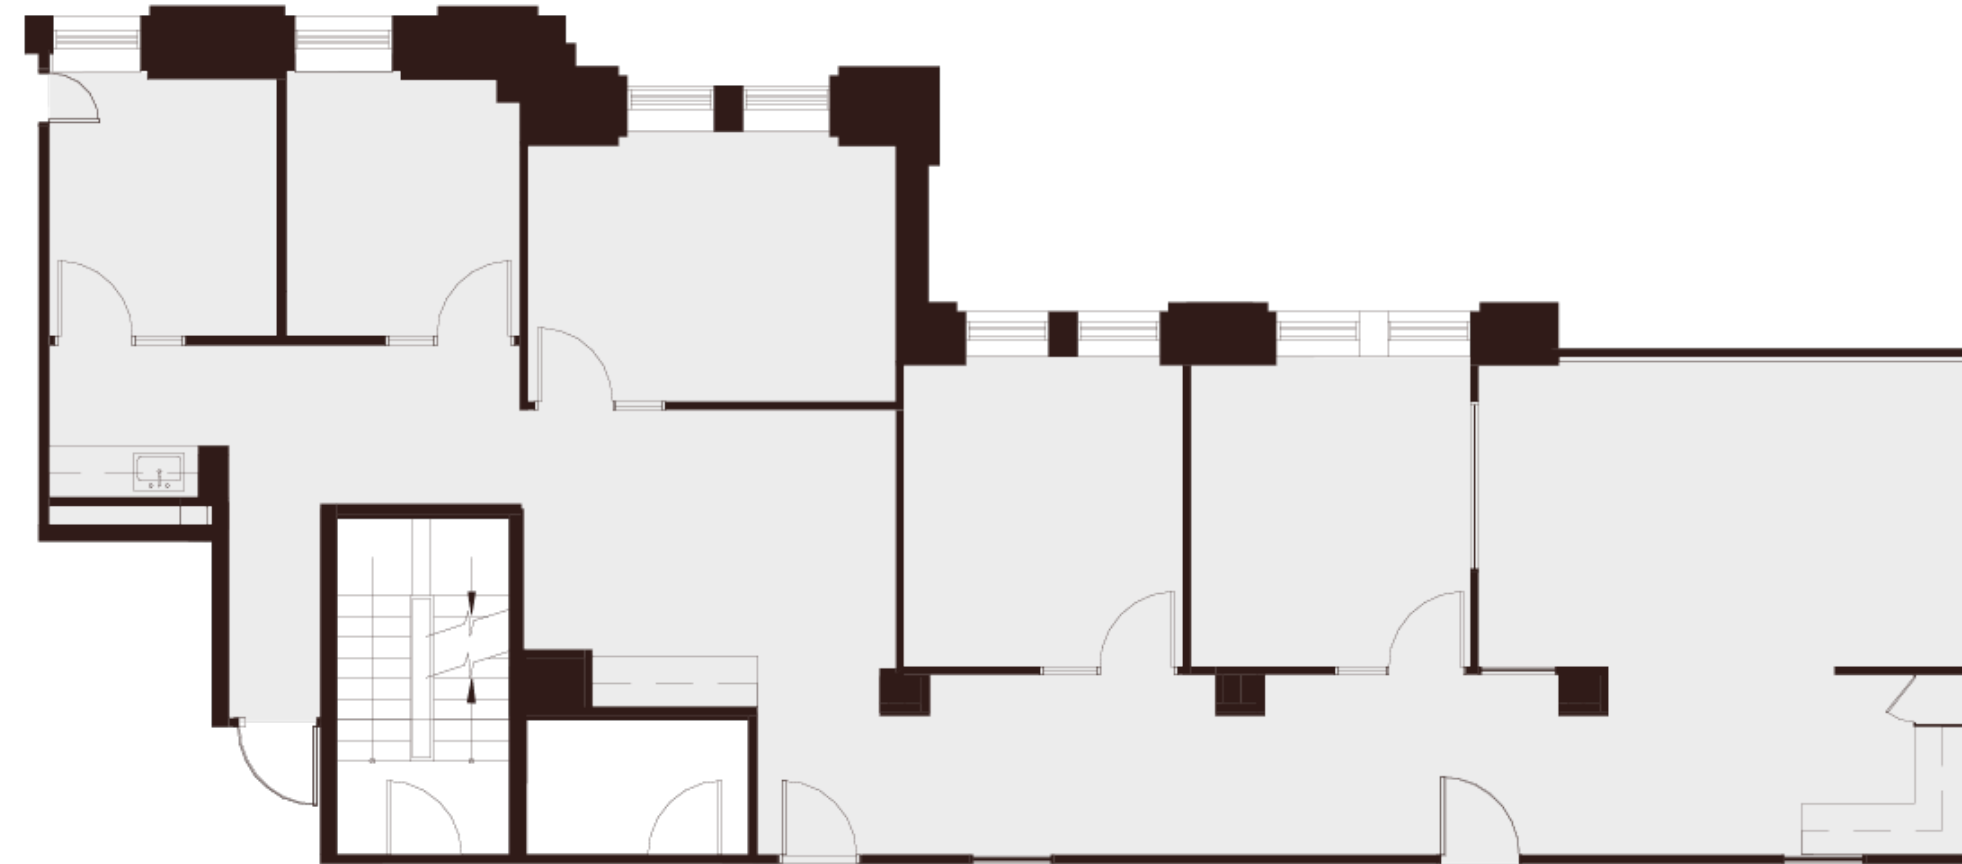

N▶



Montgomery Street



235 Montgomery St. San Francisco, CA 94104

