

Floor 10

Suite 1026

~1,345 SQFT

Low-Rise — As Built

- 2 Private Offices
- 1 Open Work Area
- 1 Break Area
- 1 Storage Room

Jim Collins



jcollins@shorenstein.com

(415) 352-7239

Lic. #00860991



235 Montgomery St. San Francisco, CA 94104

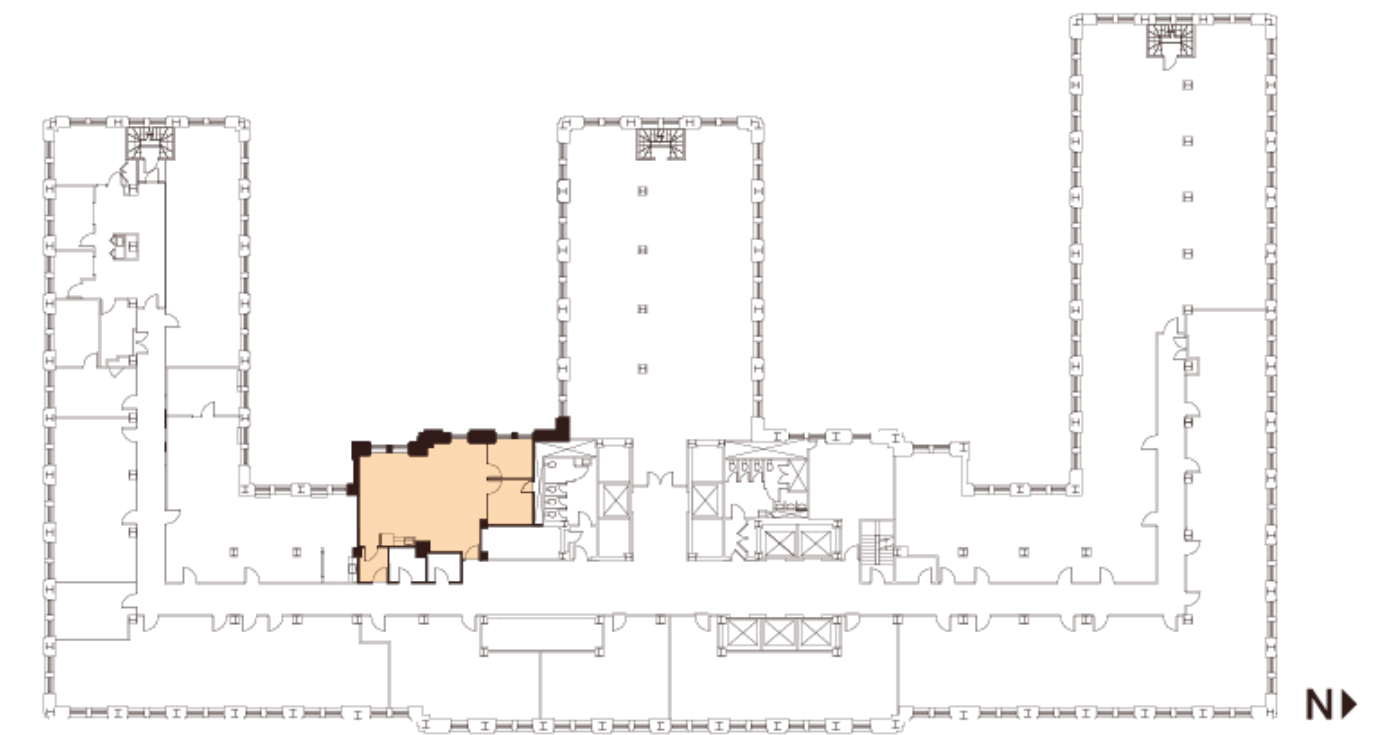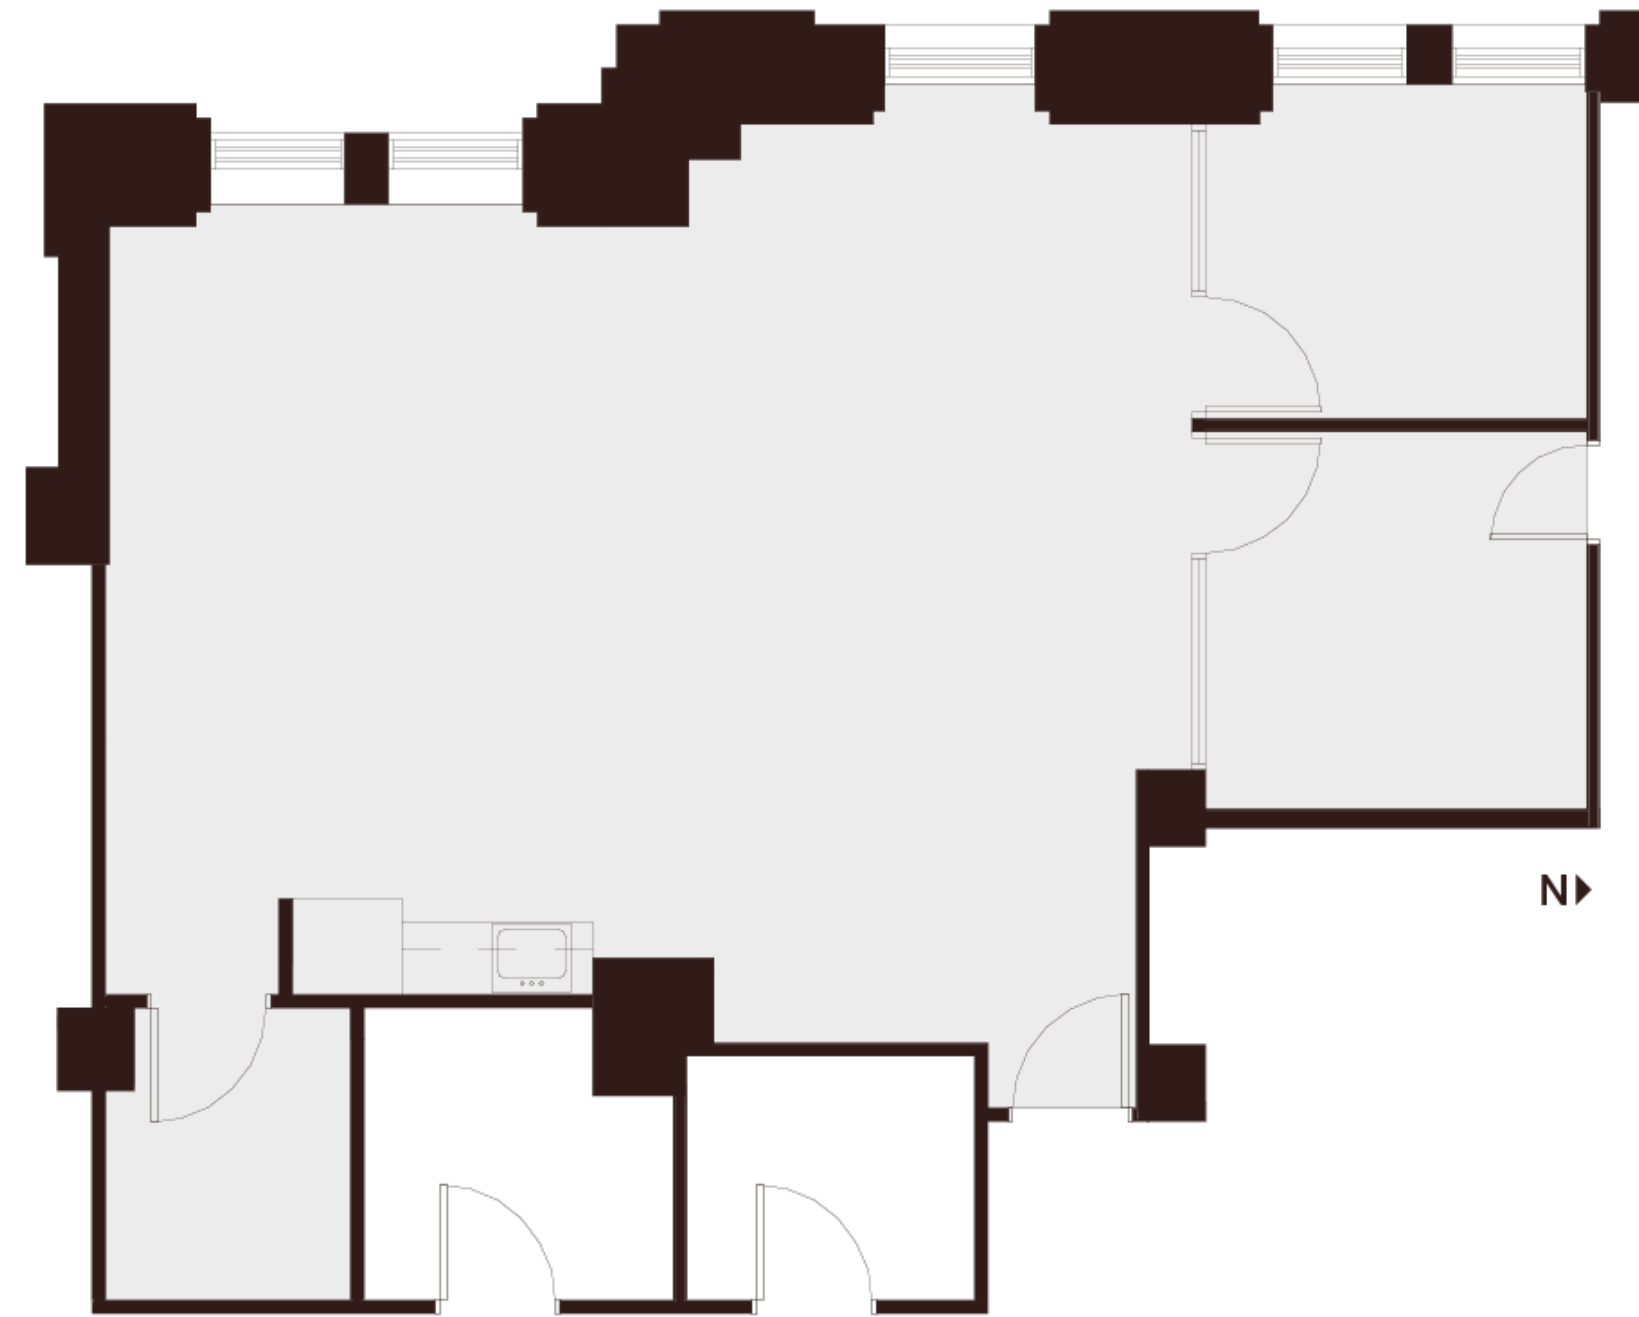

Montgomery Street