

# Floor 10

## Suite 1070

~704 SQFT

Low-Rise — As Built

- 1 Open Work Area
- 1 Break Area

Jim Collins



[jcollins@shorenstein.com](mailto:jcollins@shorenstein.com)

(415) 352-7239

Lic. #00860991



235 Montgomery St. San Francisco, CA 94104

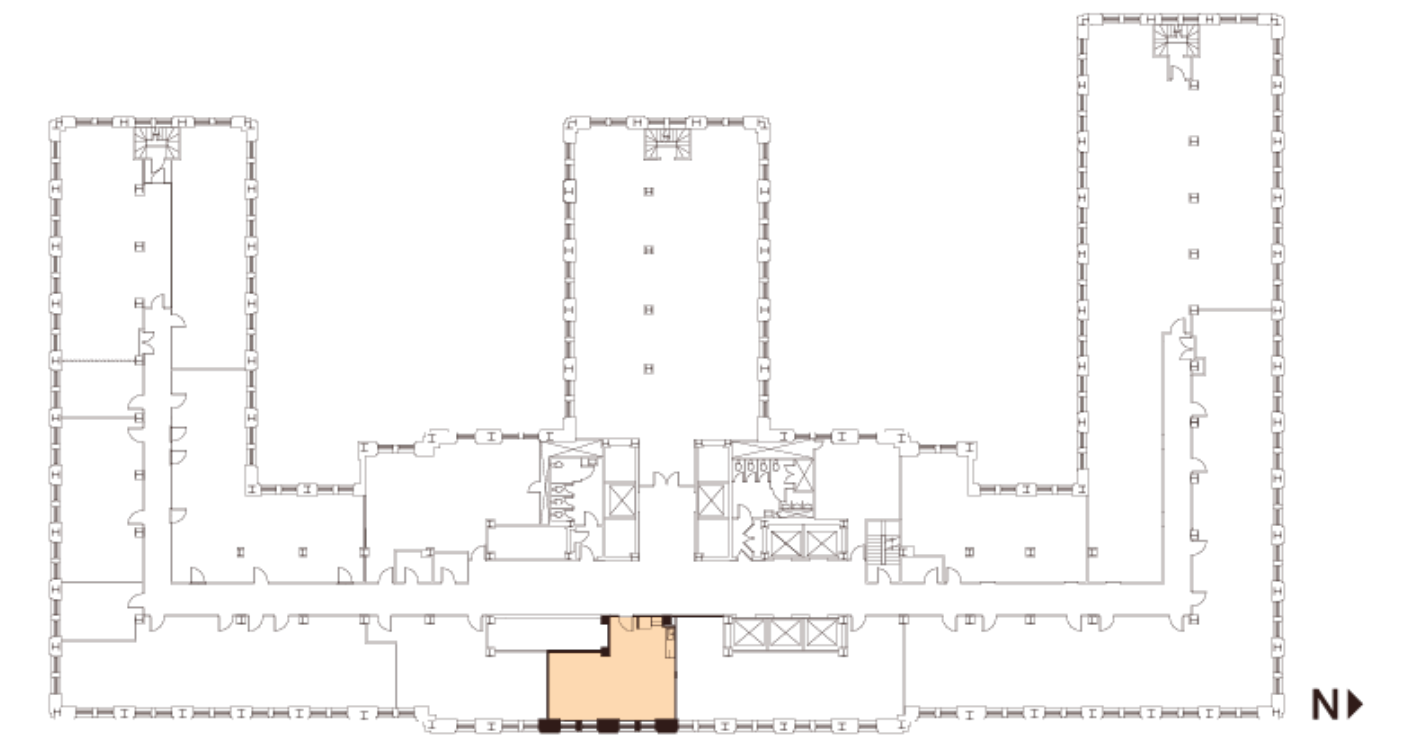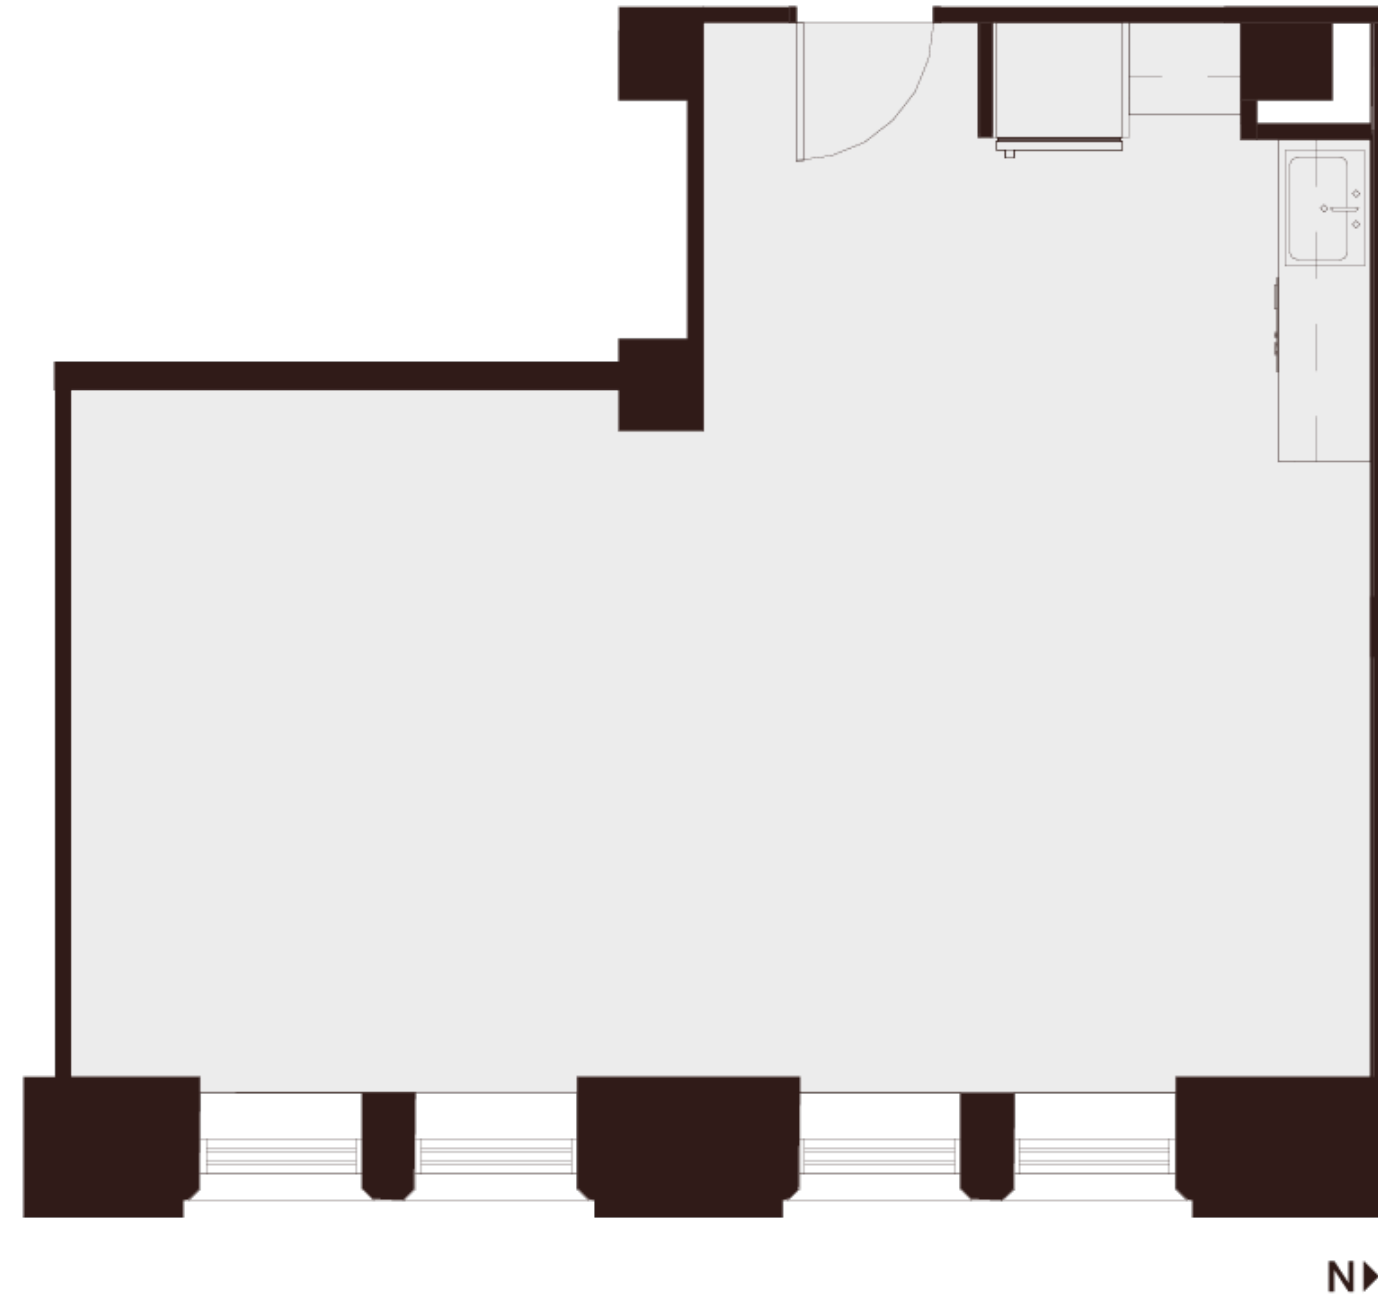

Montgomery Street