

Floor 11

Suite 1169

~1,087 SQFT

Low-Rise — As Built

- 1 Open Work Area
- 1 Conference Room
- 1 Break Area

Jim Collins



jcollins@shorenstein.com

(415) 352-7239

Lic. #00860991



235 Montgomery St. San Francisco, CA 94104

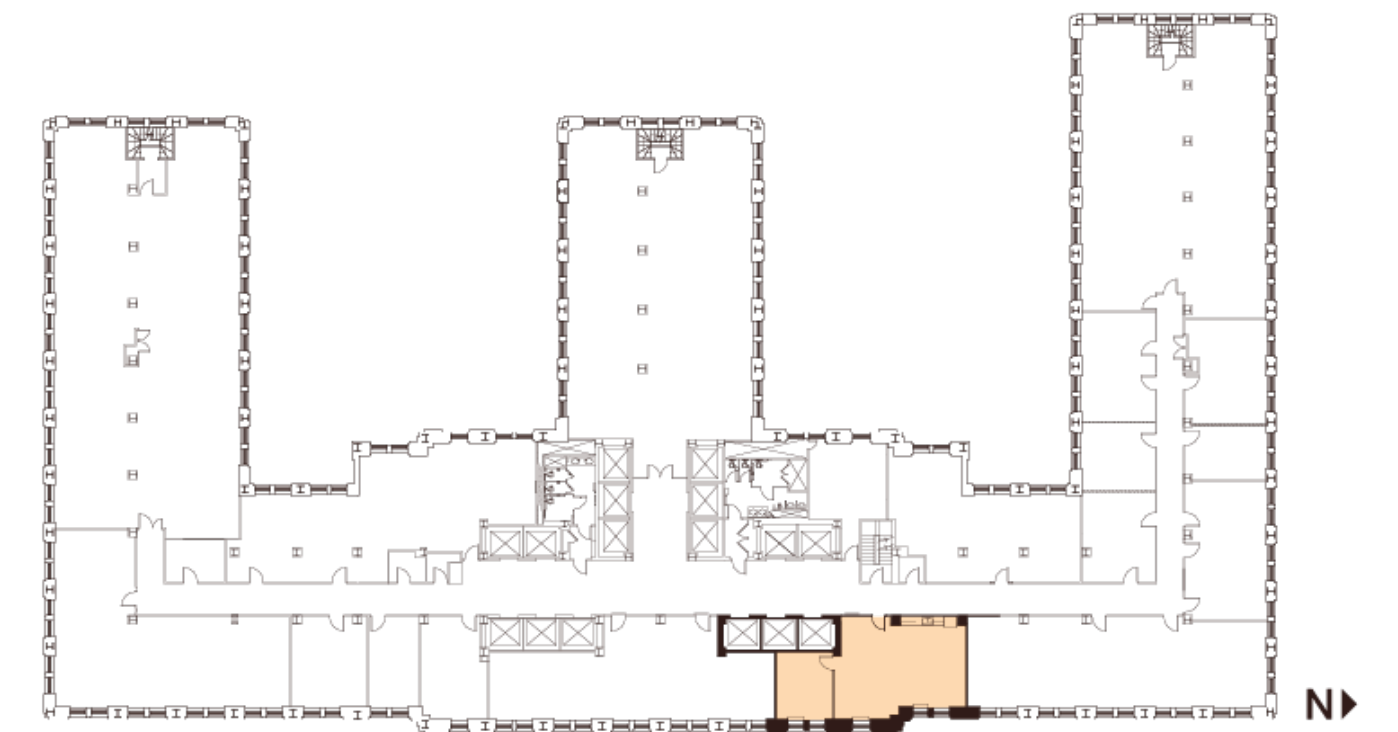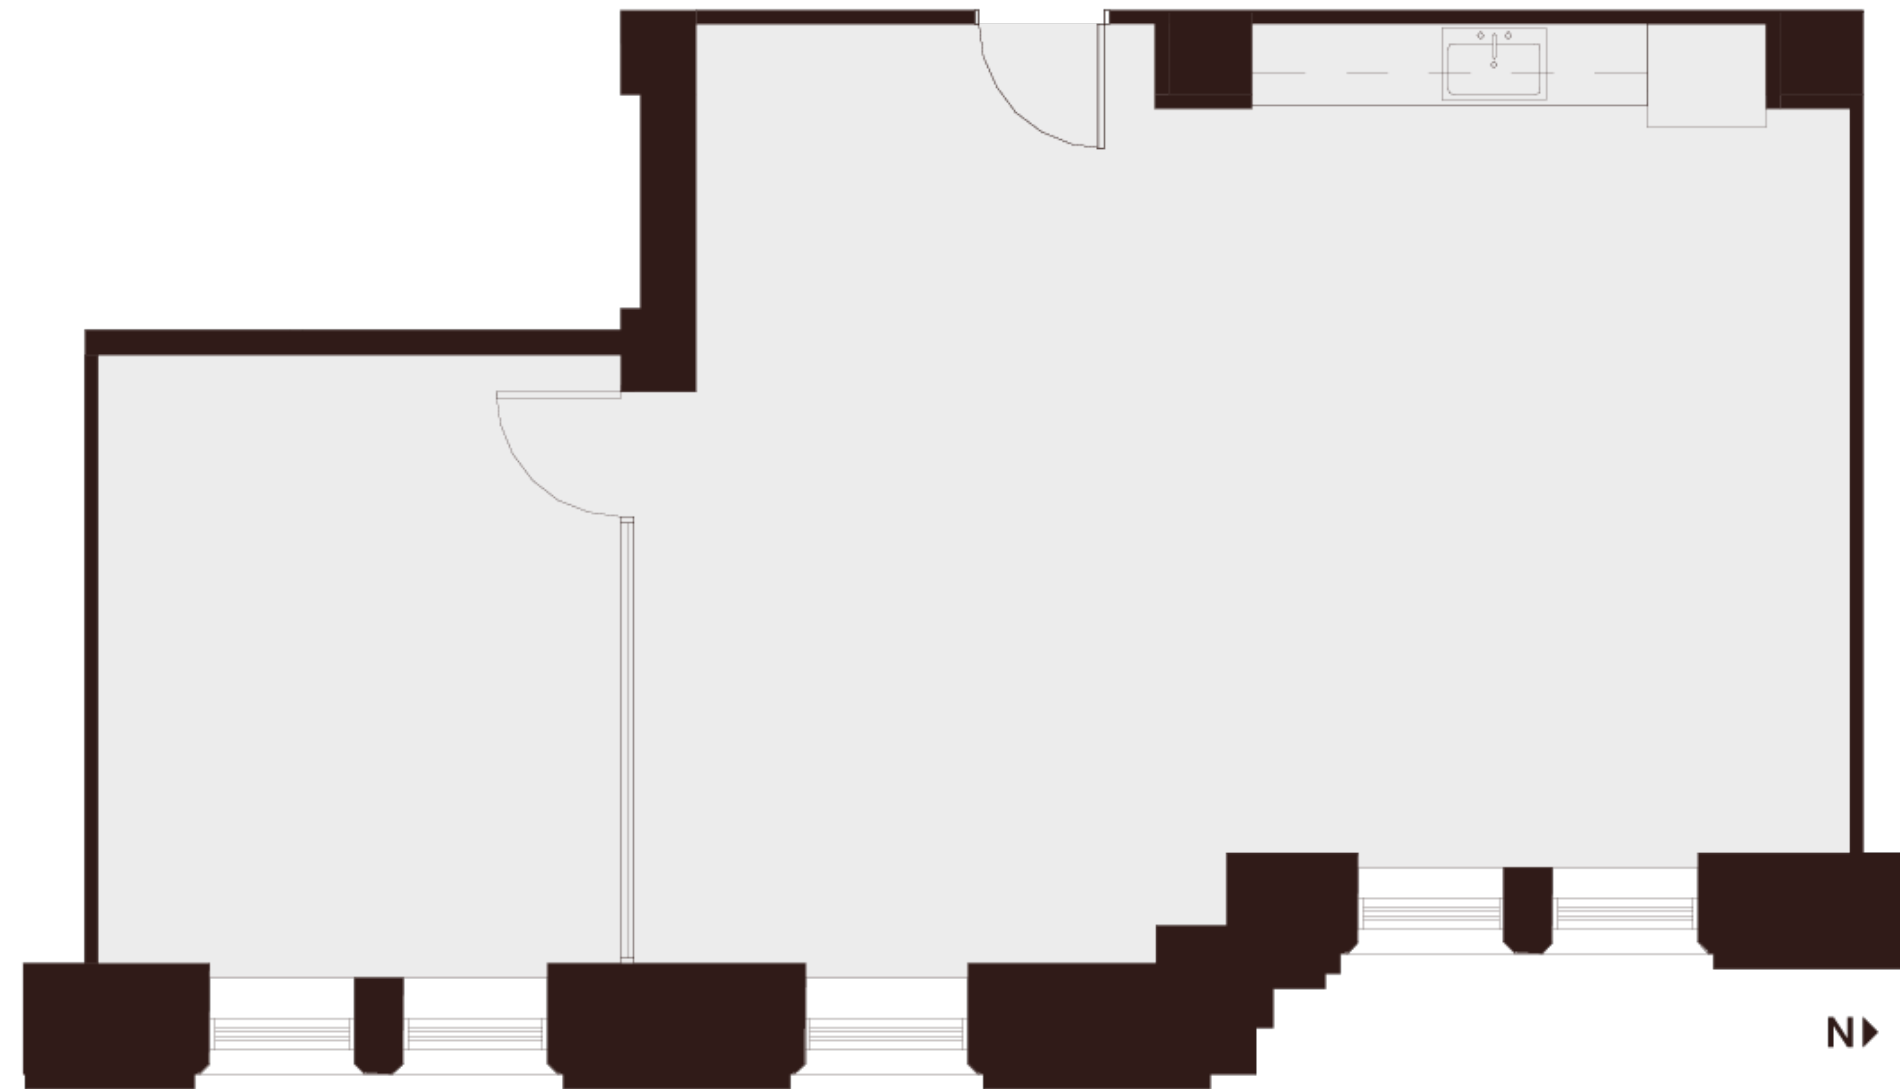

Montgomery Street