

Floor 27

Suite 2700

~6,628 SQFT

High-Rise — As Built


- 11 Private Offices
- 10 Workstations
- 1 Conference Room
- 1 Break Area
- 1 Copy Area
- 1 Reception Area
- 1 Server Room

Jim Collins

jcollins@shorenstein.com

(415) 352-7239

Lic. #00860991

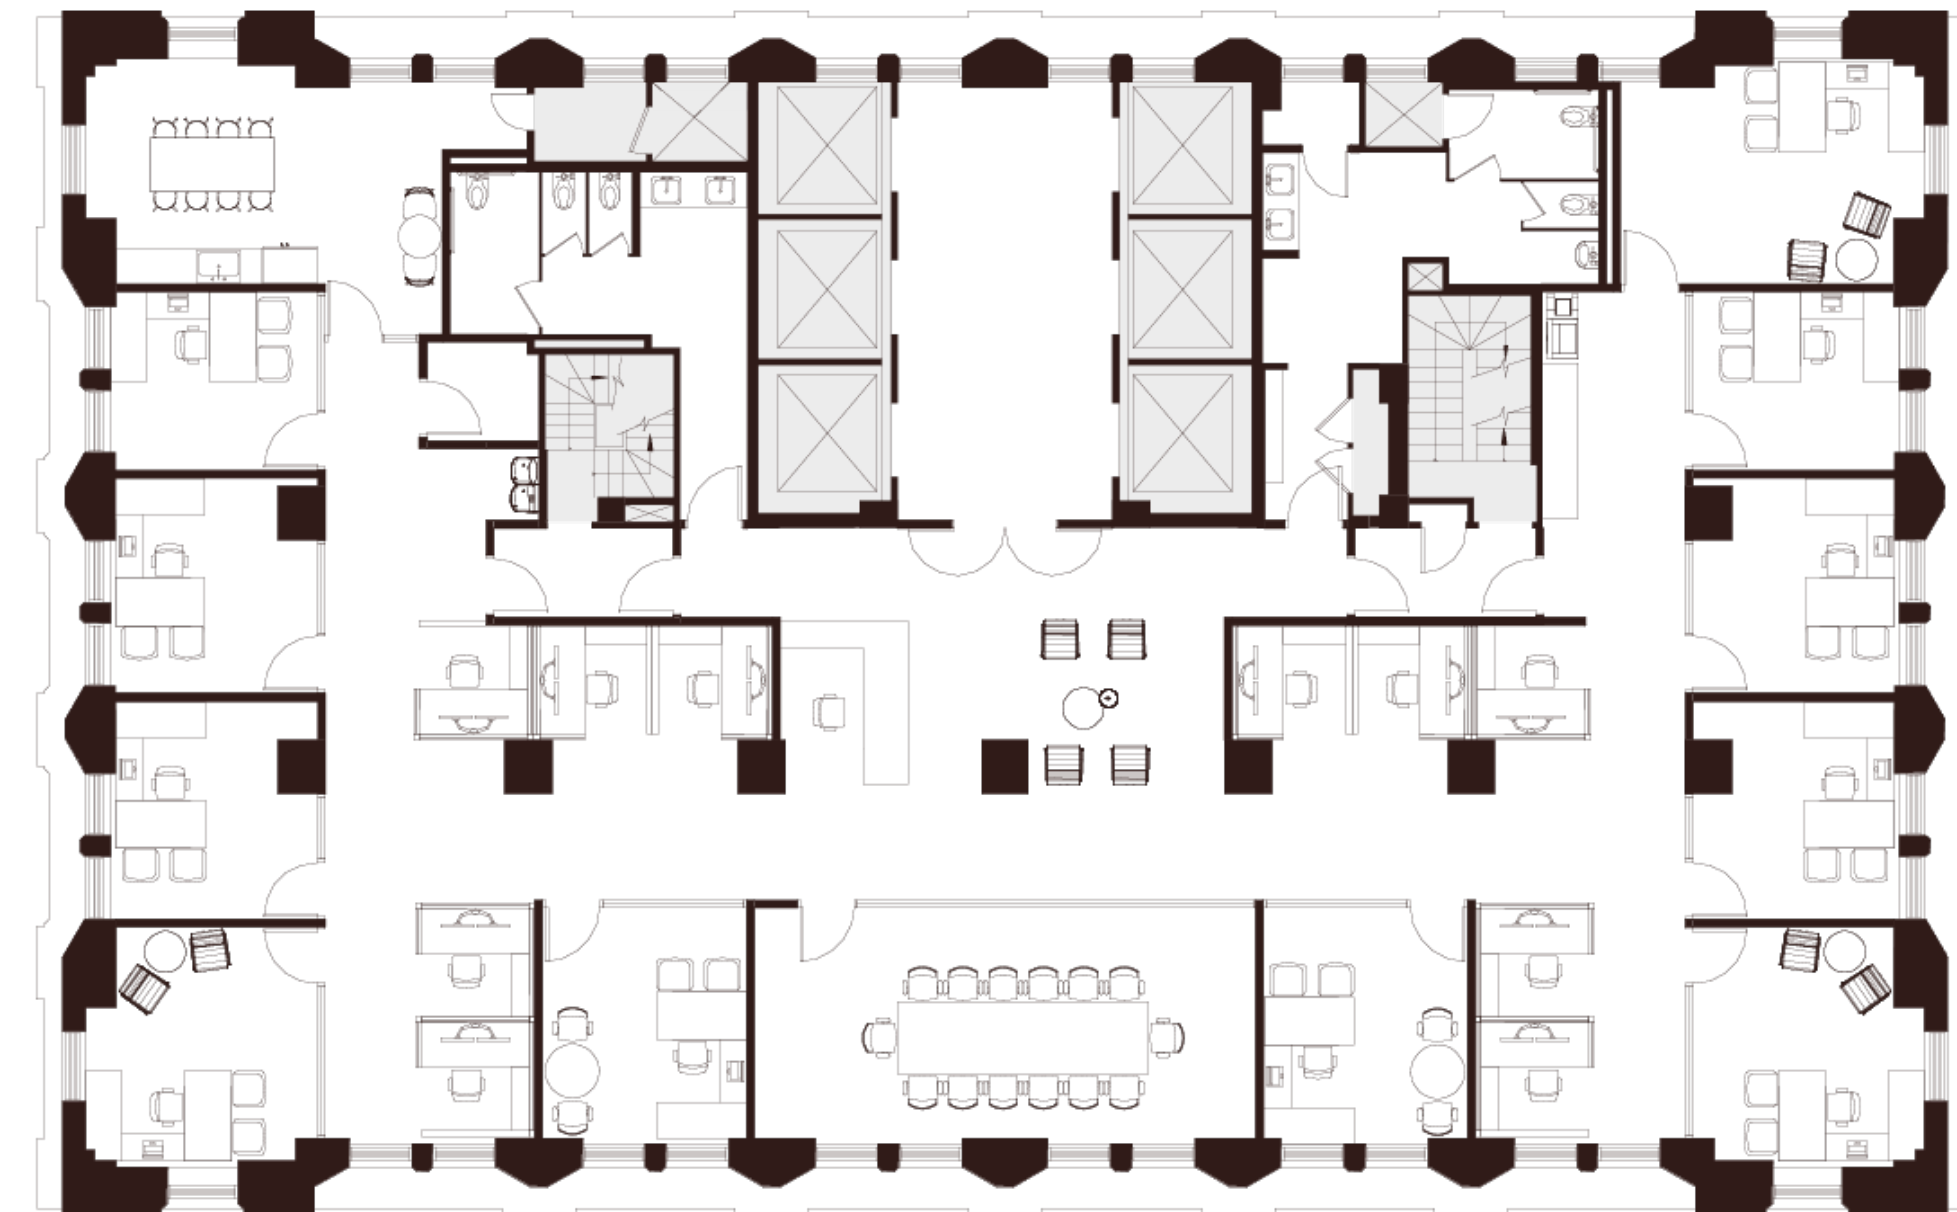

Montgomery Street



235 Montgomery St. San Francisco, CA 94104

