

Floor 18

Suite 1830

~4,029 SQFT

High-Rise — As Built

- 1 Reception Area
- 2 Corner Offices
- 6 Window Line Offices
- 1 Conference Room
- 1 Break Room with Sink, Cabinetry & Refrigerator
- 1 Open Admin Area

Jim Collins


jcollins@shorenstein.com

(415) 352-7239

Lic. #00860991



235 Montgomery St. San Francisco, CA 94104

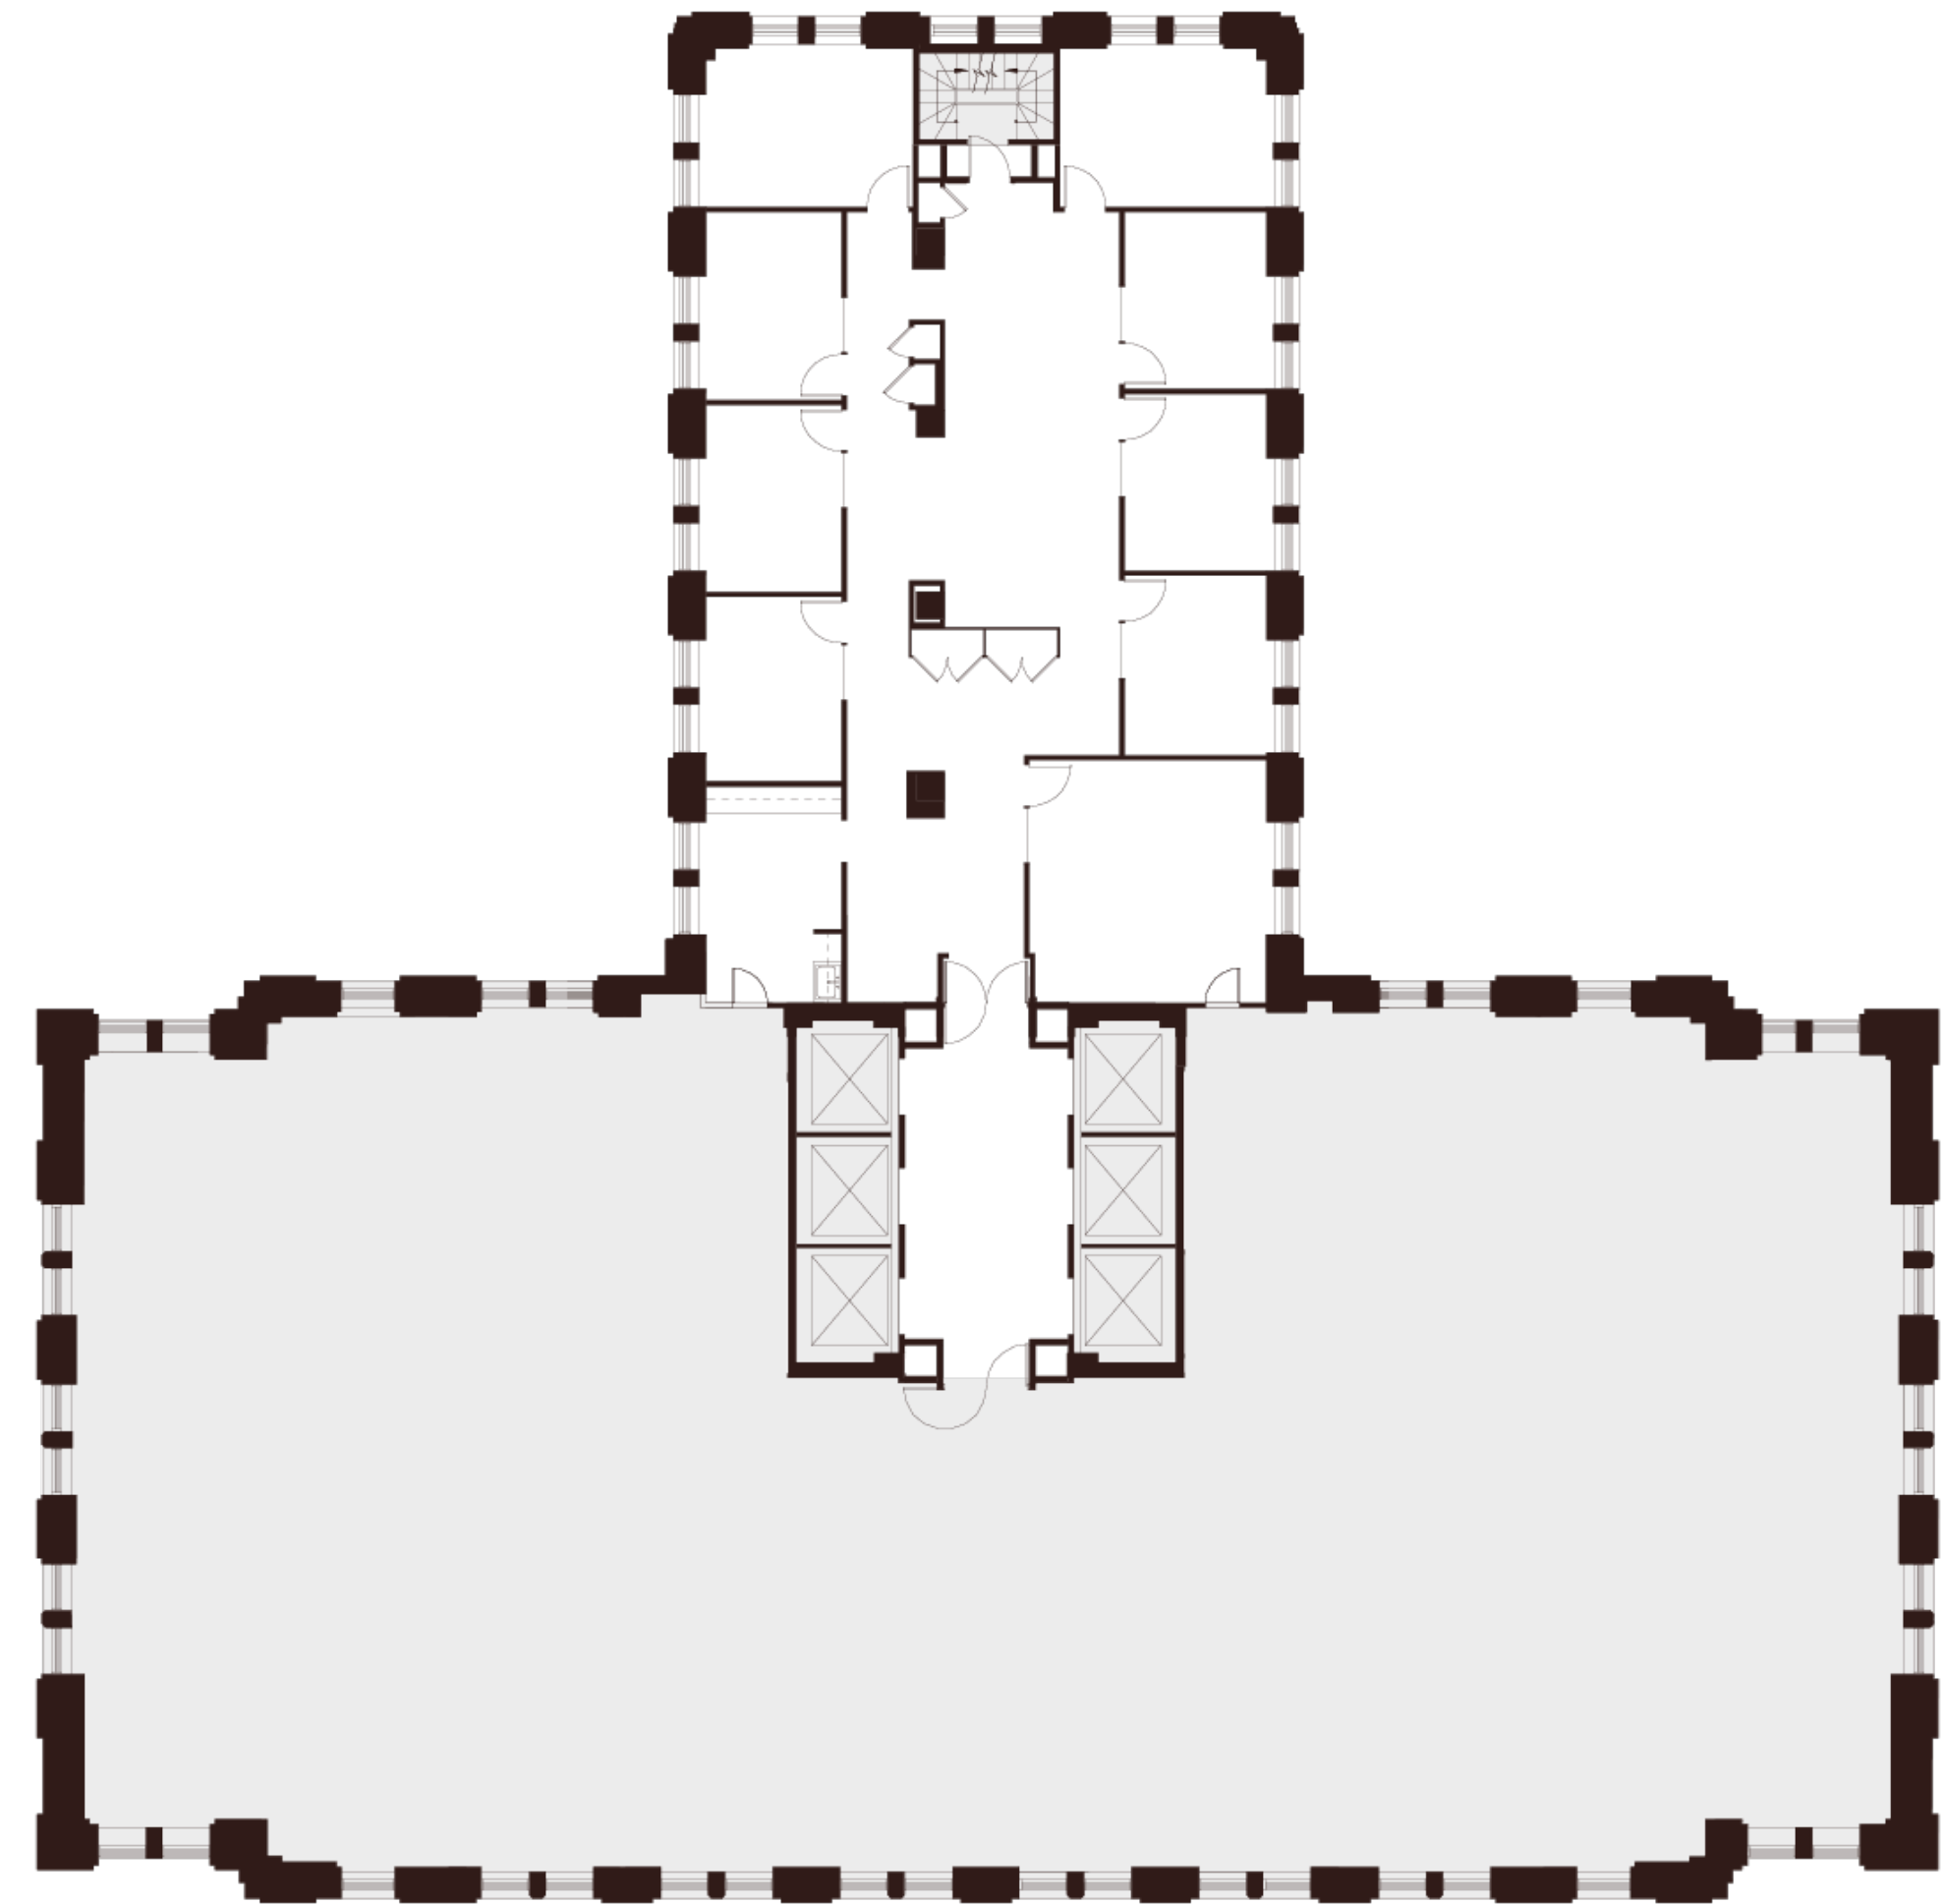

Montgomery Street

