

Floor 9

Suite 948

~1,725 SQFT

Low-Rise — As Built


- 2 Private Offices
- 1 Open Office Area
- 1 Conference Room
- 1 Break Area
- 1 Reception Area

Jim Collins

jcollins@shorenstein.com

(415) 352-7239

Lic. #00860991

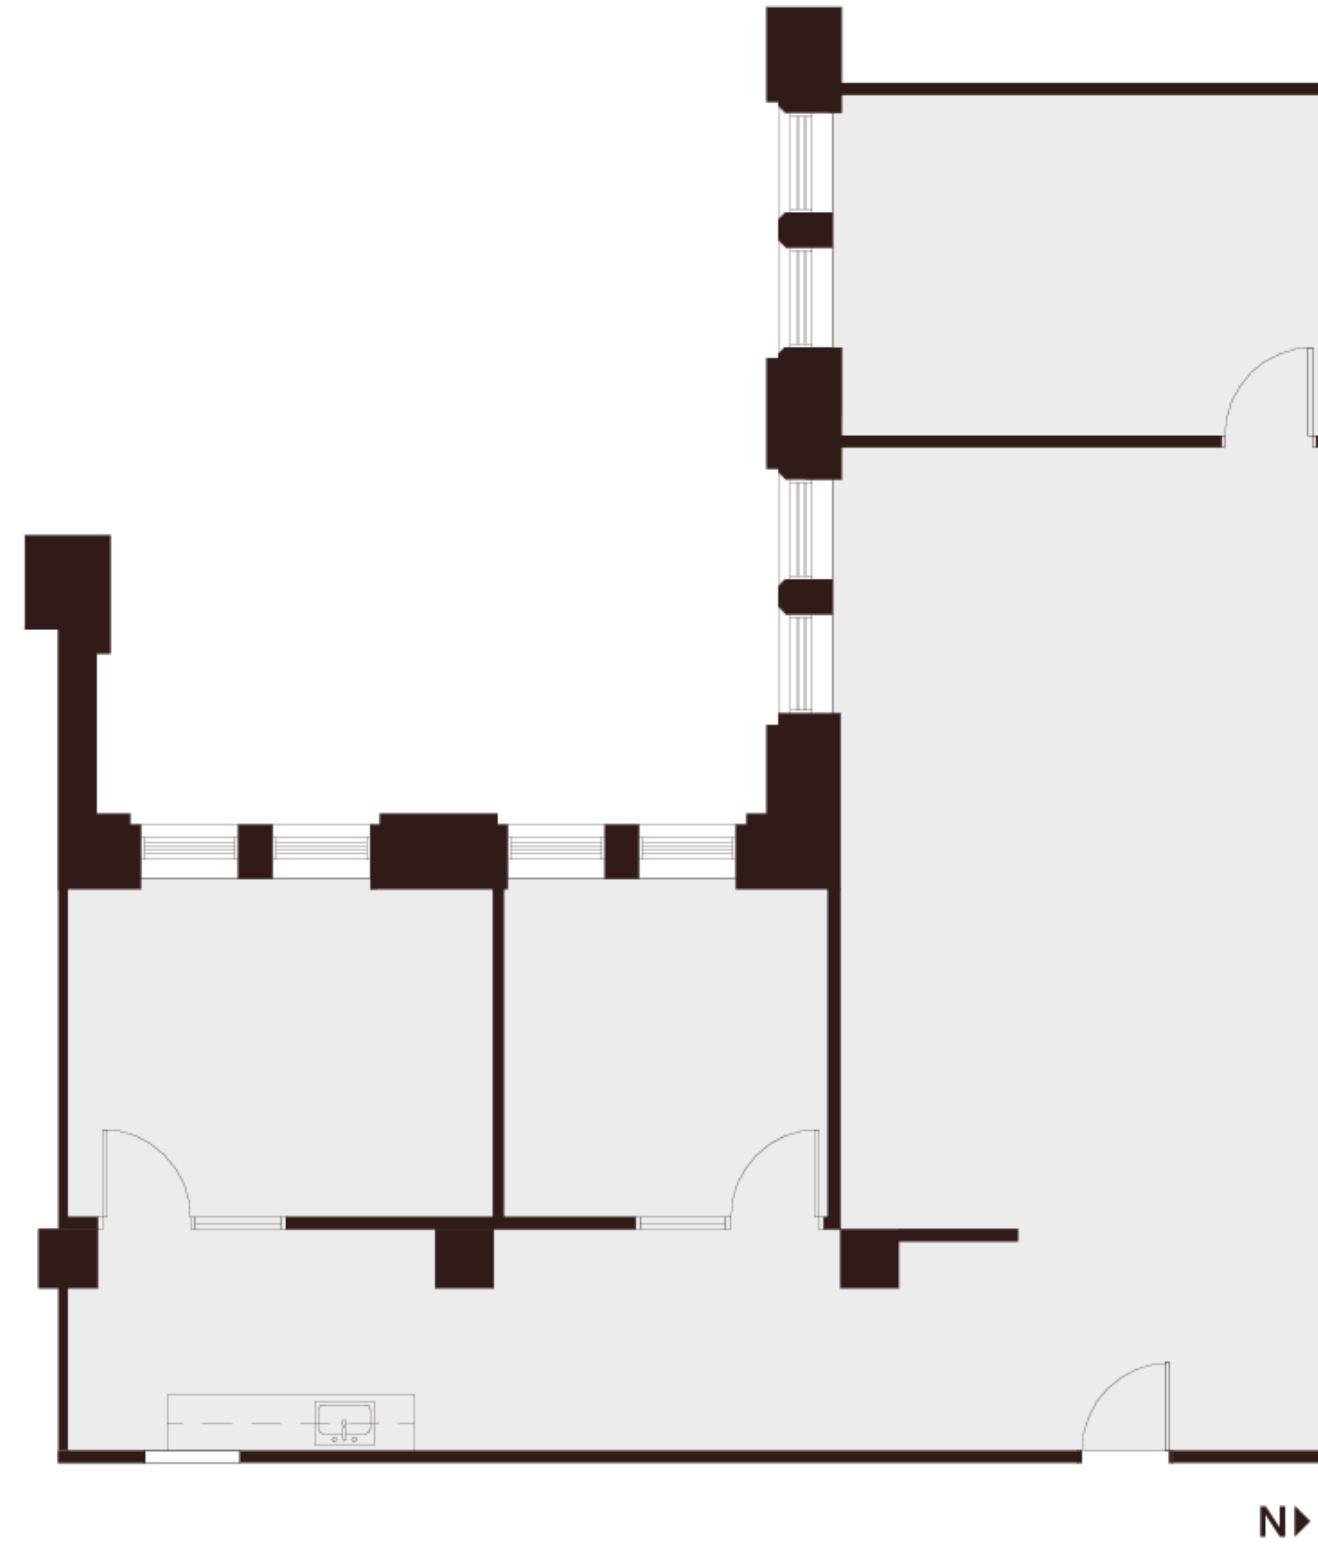

Montgomery Street



235 Montgomery St. San Francisco, CA 94104

